

Allenspach Steel offer the reassurance of full customer service, from design to installation on all projects, with a reputation for quality & attention to detail, the result you want is guaranteed every time.

It's only natural that you'll want to provide your stock with the best protection from injury & maintain their prime condition...

For this reason, Allenspach Steel are proud to use & supply the quality range of Duragal Yardrail products. Specialising in the manufacture of durable cattle handling equipment.

## crush



Above: New release crush.

Right: Rear sliding gate.

Below: Vet gates.



## head bails



Above: Rear control arm, split opening gates & squeeze.

Left: Quick release chain & head restraint.

Below: Fully open walk-thru bail.



## vet gates

- Bruise free construction
- Rear Control operation
- Safe for operator & cattle
- Vet cage area
- Silent sliding gates
- Spring gate catches
- Full access around beast
- Left or right hand operation
- Sheeted in head bail & gates
- Manufactured from 350 grade Steel
- Head lifting chain with safety release
- Anti-climb device standard on all bails
- Bail can be installed in existing crush or race

## split gates



## cattle handling equipment

## Allenspach Steel

3 Geebung Street  
Polo Flat Cooma NSW 2630

Phone: (02) 6452 5125

Fax: (02) 6452 5073

Mobile: 0408 684 283

Email: allenspa@bigpond.net.au




### race



- Easily assembled
- Optional walkway
- Silent sliding gates
- All bolted construction
- Posts welded top & bottom
- Quiet - no loose pins or panels
- Domed nuts & bolts on all rails
- Curved or straight construction
- Yardrail construction with pipe or RHS posts

### yard design

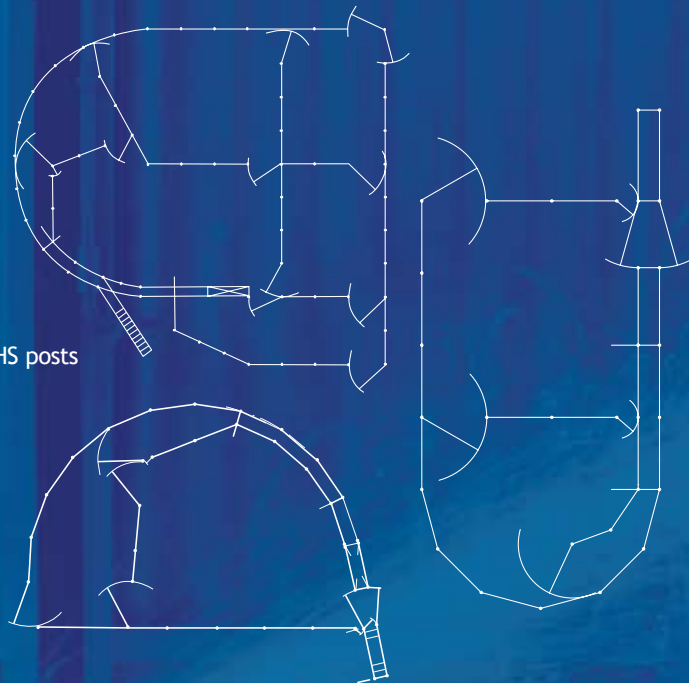

### loading ramp




- Maintenance free
- Fully concreted option
- Level loading section optional
- Walkway on one side
- Can be supplied with concrete floor formwork
- Comes complete with entry gate & 2 lead up gates


### yards



- Domed head bolts and nuts
- Smooth bruise free design
- Sliding or spring bolts on gates
- Gates made to measure to fit any yard
- Good visual barrier for cattle
- Tight, noise free construction
- Yards manufactured to your specifications

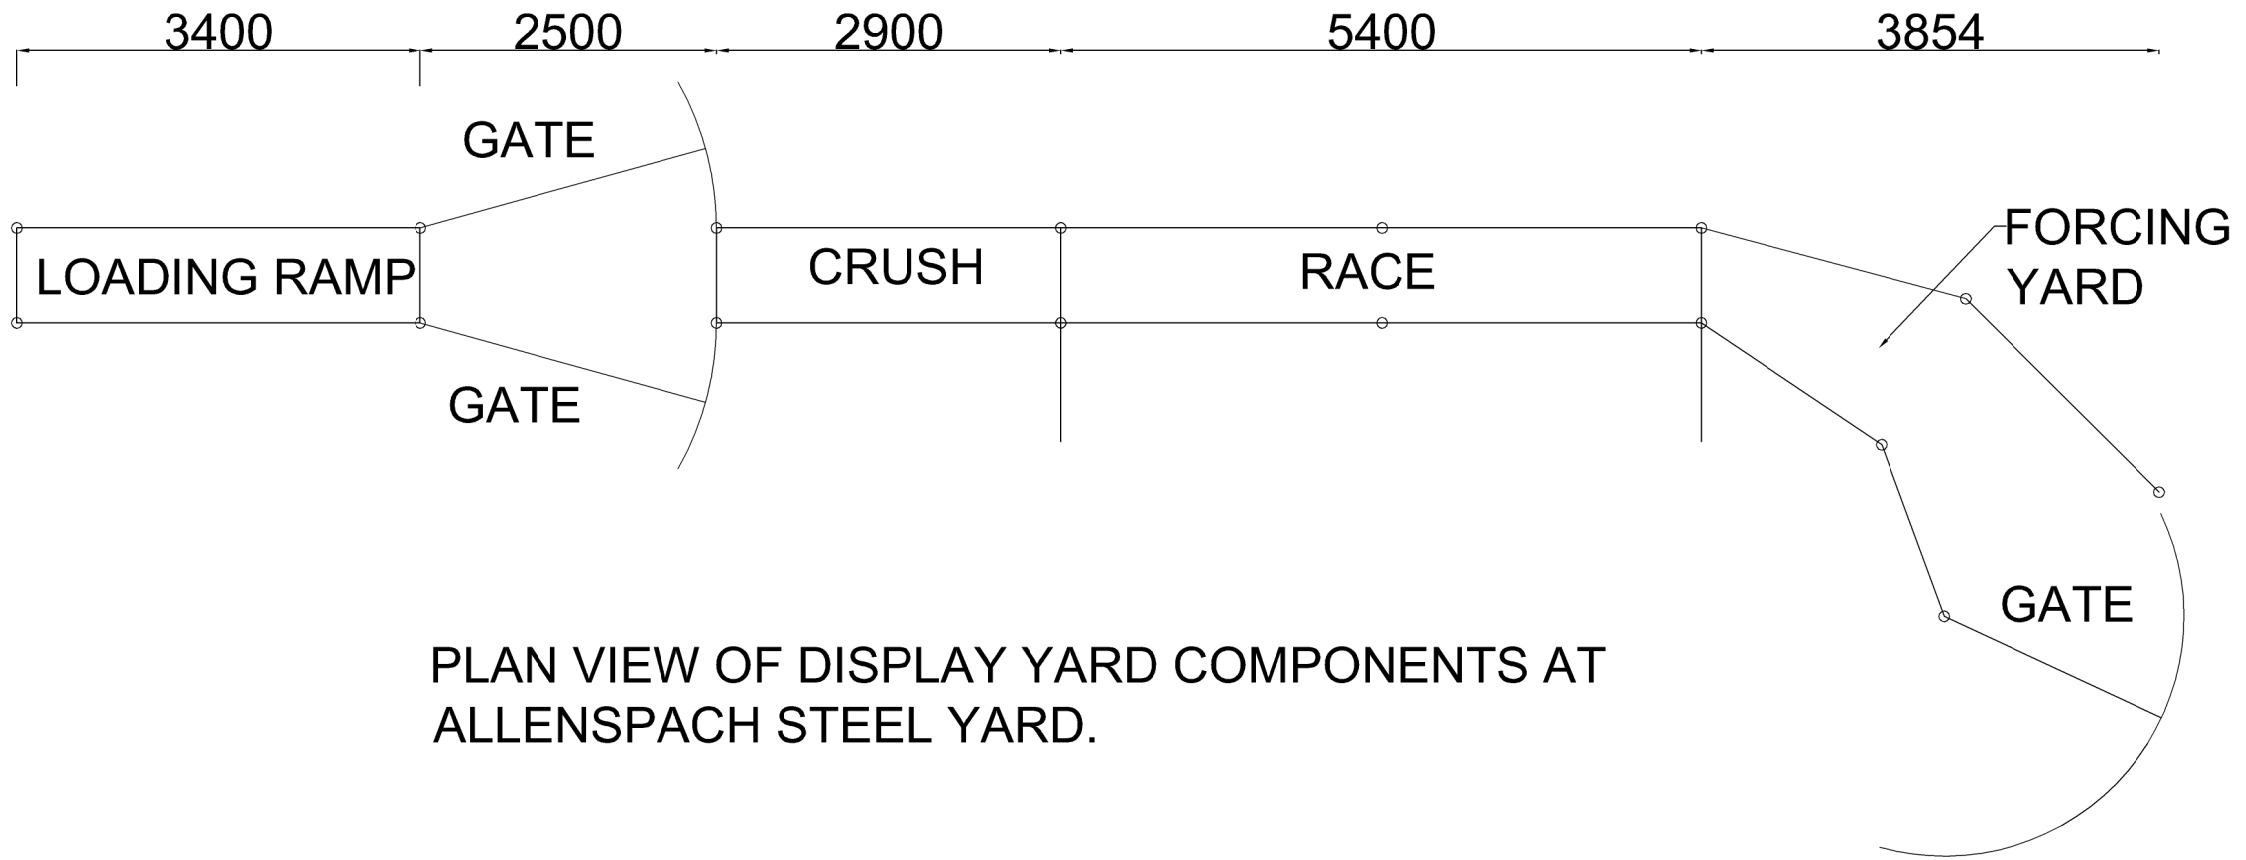

PLAN VIEW OF DISPLAY YARD COMPONENTS AT ALLENSPACH STEEL YARD.

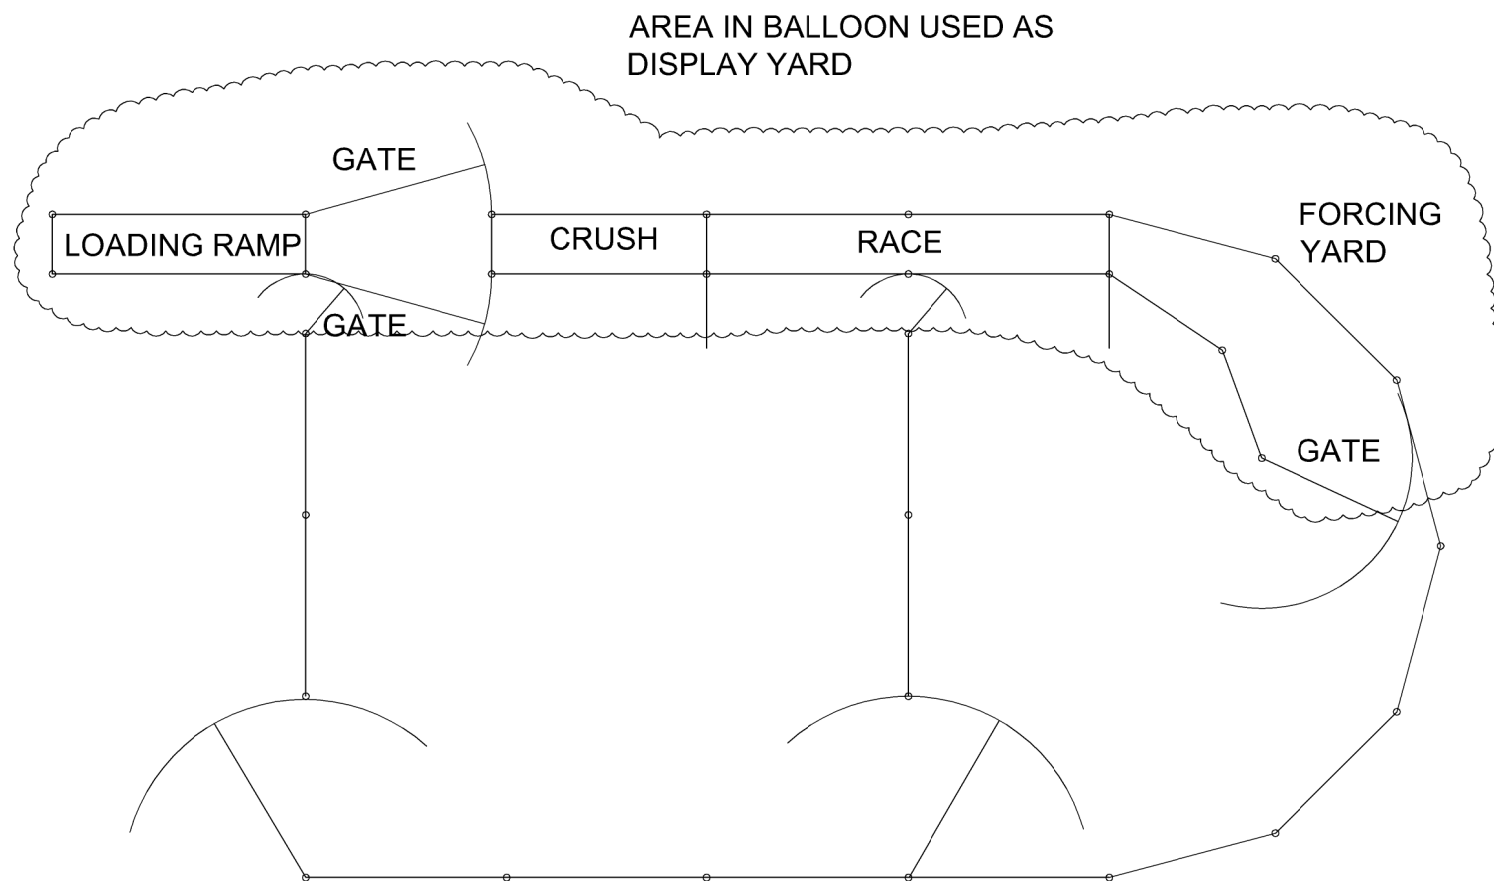

PLAN VIEW OF TYPICAL 2 PEN 'D' TYPE YARD

NOTES;

- POSTS EX 88MM OD PIPE CONCRETED IN GROUND
- ALL PANELS, RACE & LOADING RAMP 5 RAIL 115X40 YARDRAIL
- GATES 6 RAIL EX 42MM OD GAL PIPE WITH SLIDING LOCKBOLTS.
- LOADING RAMP WITHOUT FLOOR. (RECOMMEND USING CONCRETE TYPE OF BASE, FORMWORK TO SUIT AVAILABLE FOR USE)

		CLIENT:		DRAWING No:	
LOT 3 GEEBUNG ST POLO FLAT COOMA 2630 PH 6452515		PROJECT: DISPLAY CATTLE YARD		AS-DY-001-A	
DATE:	3/01/25	ISSUED FOR FABRICATION	PA	SCALE:	NTS
TITLE: OVERALL LAYOUT			DRAWING STATUS: AS BUILT		
COPYRIGHT © ALLENSPACH STEEL ALL RIGHTS RESERVED				<b>A</b>	